


Contents: Davis H. Hart Career Center – Controls Installation

Drawing # Drawing Title

- 0.0 Cover - Sheet
- 1.0 Riser - Diagram
- 1.1 Communication Bus - Routing
- 1.2 NAE - Panel Layout
- 2.0 RTU's - Flow & Controller Diagram
- 3.0 VVT's - Flow & Controller Diagram
- 4.0 HVU's - Flow & Controller Diagram
- 5.0 EUHs - Controller Diagram



XEC, Inc.
7932 Nieman Rd.
Lenexa, KS 66214
P: 913.563.4260
F: 913.563.4269
www.xeccinc.com

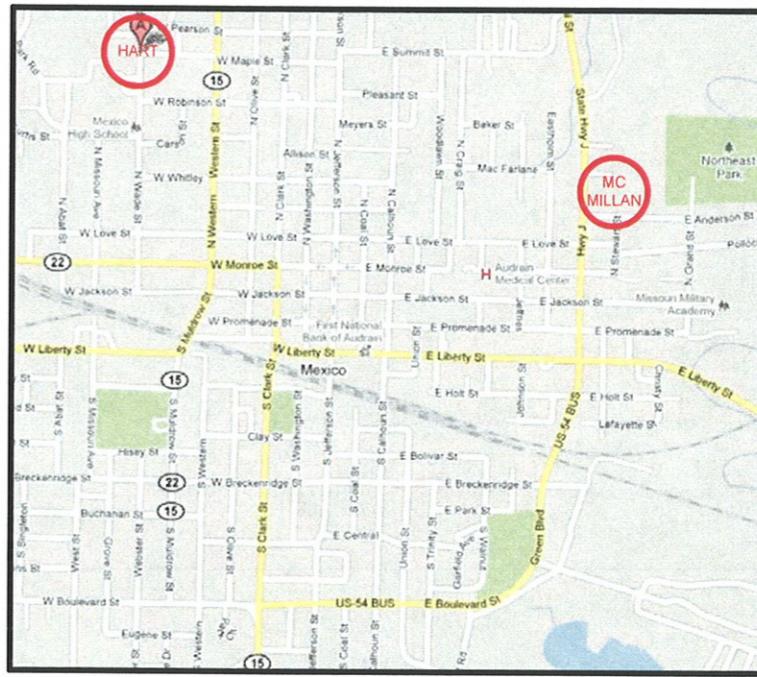

MCMILLAN ELEMENTARY SCHOOL
1101 E ANDERSON ST
MEXICO, MO 65265

DAVIS H. HART CAREER CENTER
905 N. WADE
MEXICO, MO 65265

Chevron Energy Solutions	
NOTE: Approval applies only to general conformity with Engineer's plans and specifications. Approval does not guarantee accuracy of detail dimensions or quantities	
<input type="checkbox"/> APPROVED	<input type="checkbox"/> REVISE
<input checked="" type="checkbox"/> APPROVED AS NOTED	<input type="checkbox"/> REVISE AND RESUBMIT
<input type="checkbox"/>	
SIGNATURE	
PRINT NAME	Aaron Cox
DATE	4/29/11

TYPICAL WRE SIZE UNLESS NOTED
N2 BUS 18/3
FC BUS 22/3
SA BUS 22AWG/2PAIR
CONTROL WIRE 18AWG
24VAC POWER 14AWG


- TERMINAL STRIP TAG
- SINGLE WRE TAG
- COMPONENT TERMINAL /TAG
- WRE GROUP TAG
- PNEUMATIC TAG

Project Title	
Mexico Public Schools - Controls Installation	REVISIONS
Project Title	
905 North Wade	
Mexico, MO 65265	

FILE NAME	MPS.Hart Career Center.Submittal.vsd
DRAWN BY	CB
DATE	4/20/2011 2:53:05 PM
Sales Engineer	TJB
Project Manager	MAR
Project Engineer	CB
Drawing Title	Cover Sheet Submittal Drawing
Contract Number	C1-6009
Drawing Number	0.0



XEC, Inc.
7932 Nieman Rd.
Lenexa, KS 66214
P: 913.563.4260
F: 913.563.4269
www.xeccinc.com

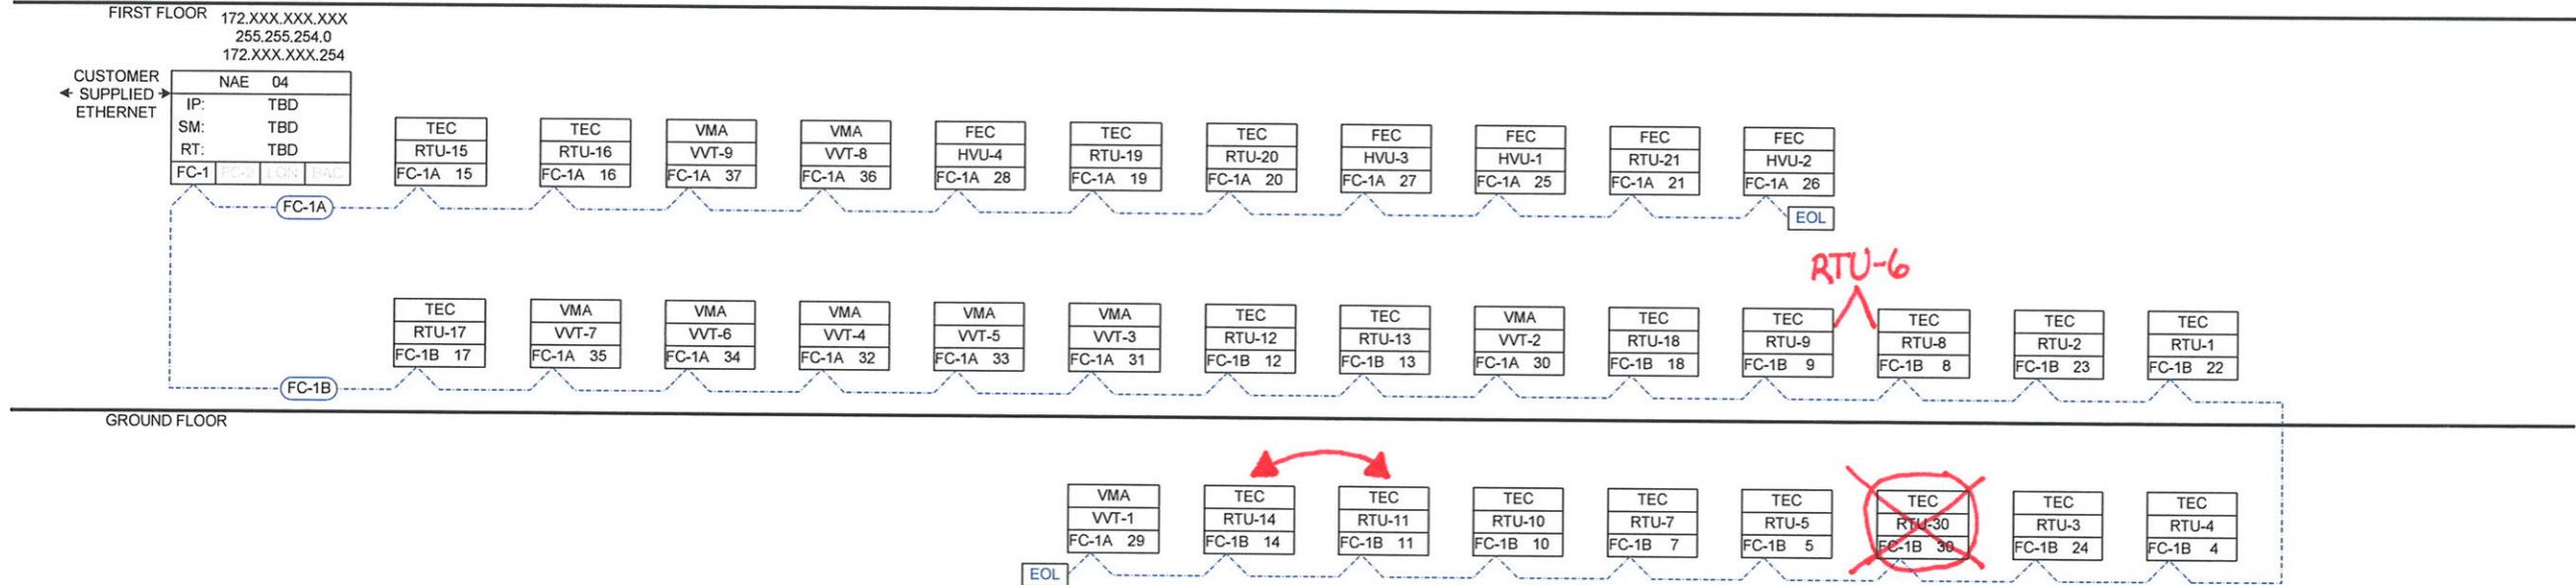

Project Title	Mexico Public Schools - Controls Installation	
Location	905 North Wade	
City	Mexico, MO 65265	
Revisions		

Bill of Material		
Item	QTY	Part
EOL	2	MS-BACEOL-0


Drawing Title	Riser Hart Career Center Diagram	Submittal Drawing
FILE NAME	MPS.Hart Career Center.Submittal.vsd	
DRAWN BY	TJB	
Sales Engineer		
Project Manager	MAR	
Project Engineer	CB	
CONTRACT NUMBER	C1-6009	
DRAWING NUMBER	1.0	



Project Title	Mexico Public Schools - Controls Installation
Location	905 North Wade Mexico, MO 65265
REVISIONS	

FILE NAME:	MPS.Hart Career Center-Submittal.vsd	DRAWN BY:	TJB
Sales Engineer		DATE:	4/20/2011 2:53:05 PM
Project Manager	MAR		
Project Engineer	CB		

CONTRACT NUMBER	C1-6009
DRAWING NUMBER	1.1

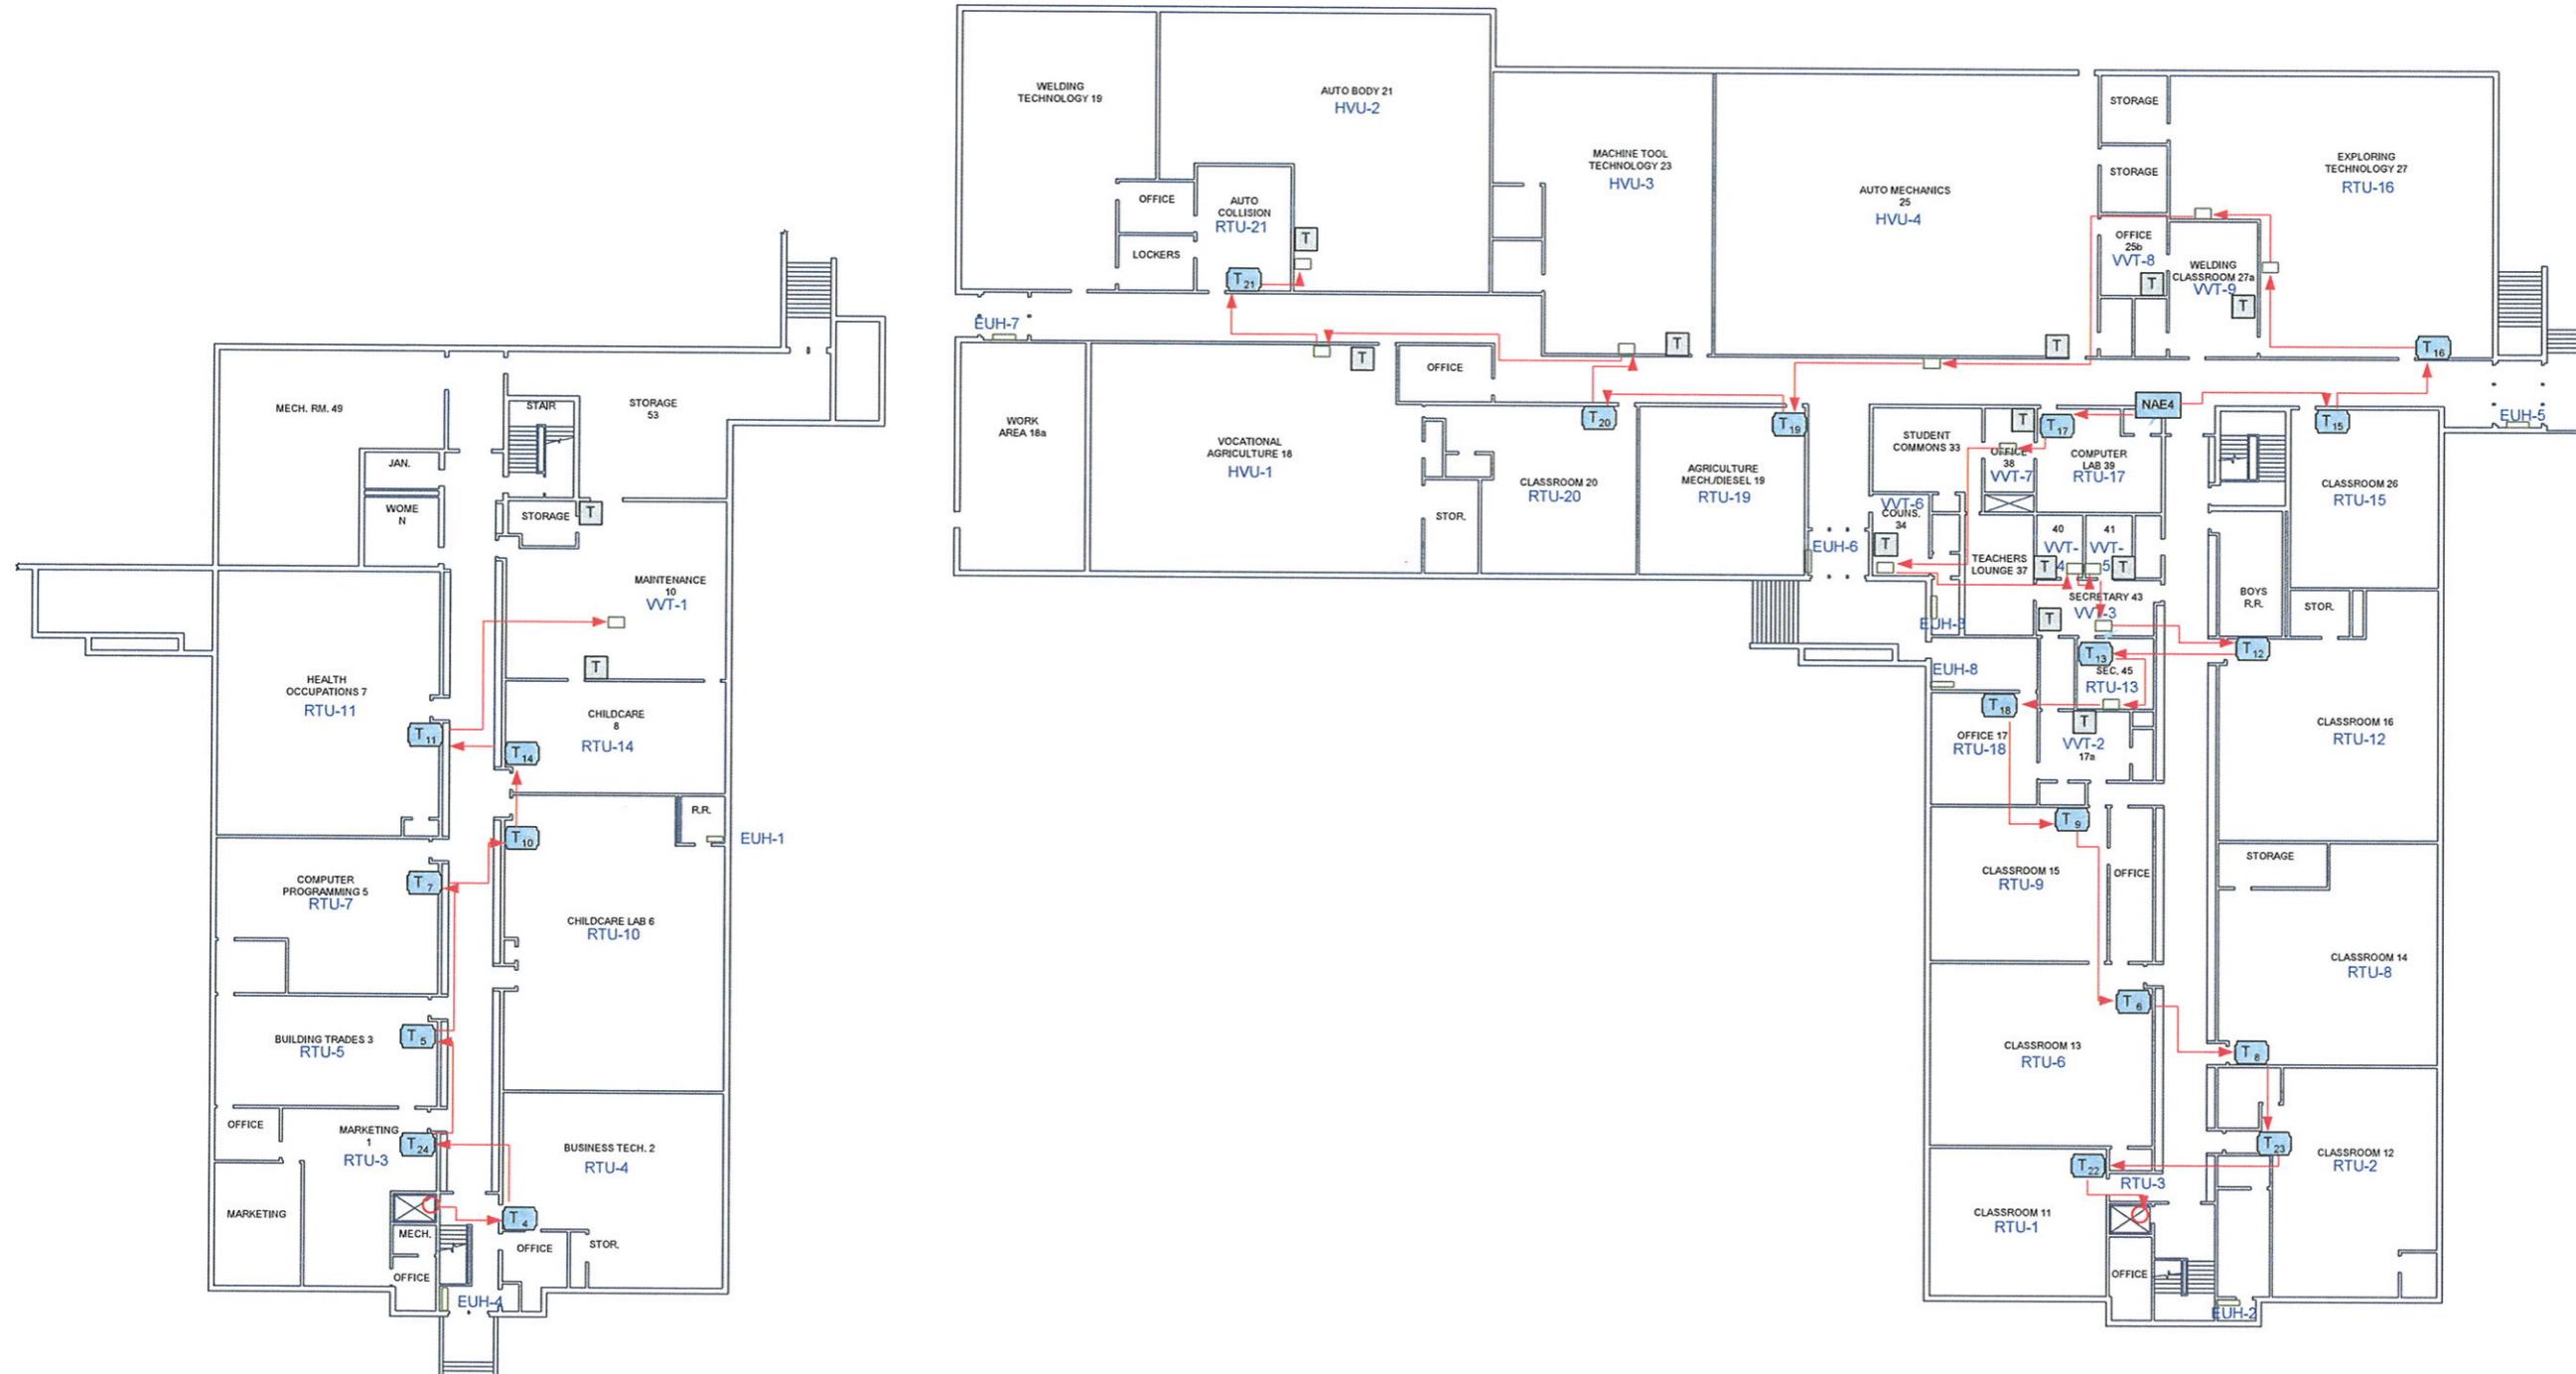





XEC, Inc.
7932 Nieman Rd.
Lenexa, KS 66214
P: 913.563.4260
F: 913.563.4269
www.xeccinc.com



Bill of Material		
Item	QTY	Part
DIN	1	BAM-1000
ENC	1	RET2620ULP
NAE04	1	MS-NAE3510-2
SW/R	1	S1T20W, RD20W, 4BX21834, 4BXCVRATGDU
TERM	1	M4/6-BK
TERM	1	M4/6-BG
TERM	1	M4/6P
TERM	4	BAM2
TERM	2	FEM6
TX	1	X100CBB

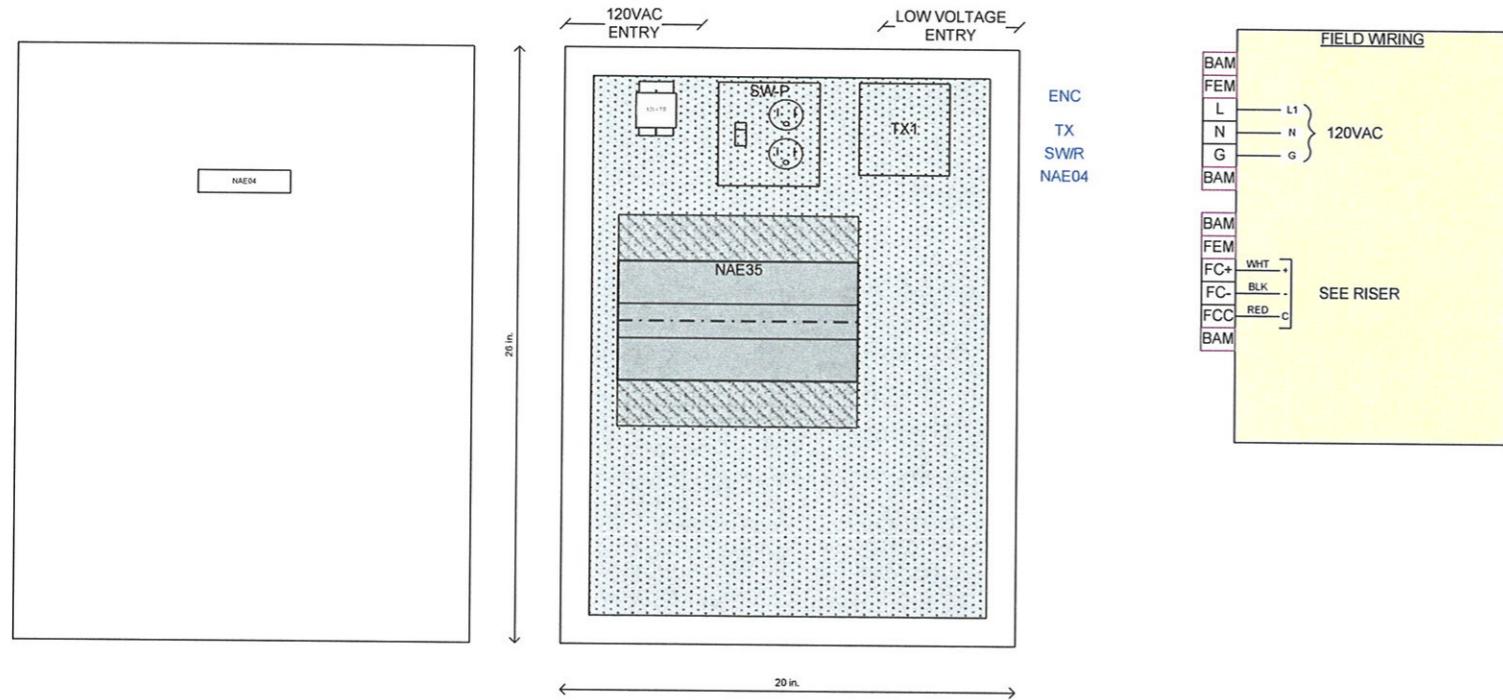

Project Title	Mexico Public Schools - Controls Installation 905 North Wade Mexico, MO 65265	
FILE NAME	MPS.Hart Career Center.Submittal.vsd	
DRAWN BY	CB	DATE 4/20/2011 2:53:05 PM
Sales Engineer	TJB	
Project Manager	MAR	
Project Engineer	CB	
CONTRACT NUMBER	C1-6009	
DRAWING NUMBER	1.2	

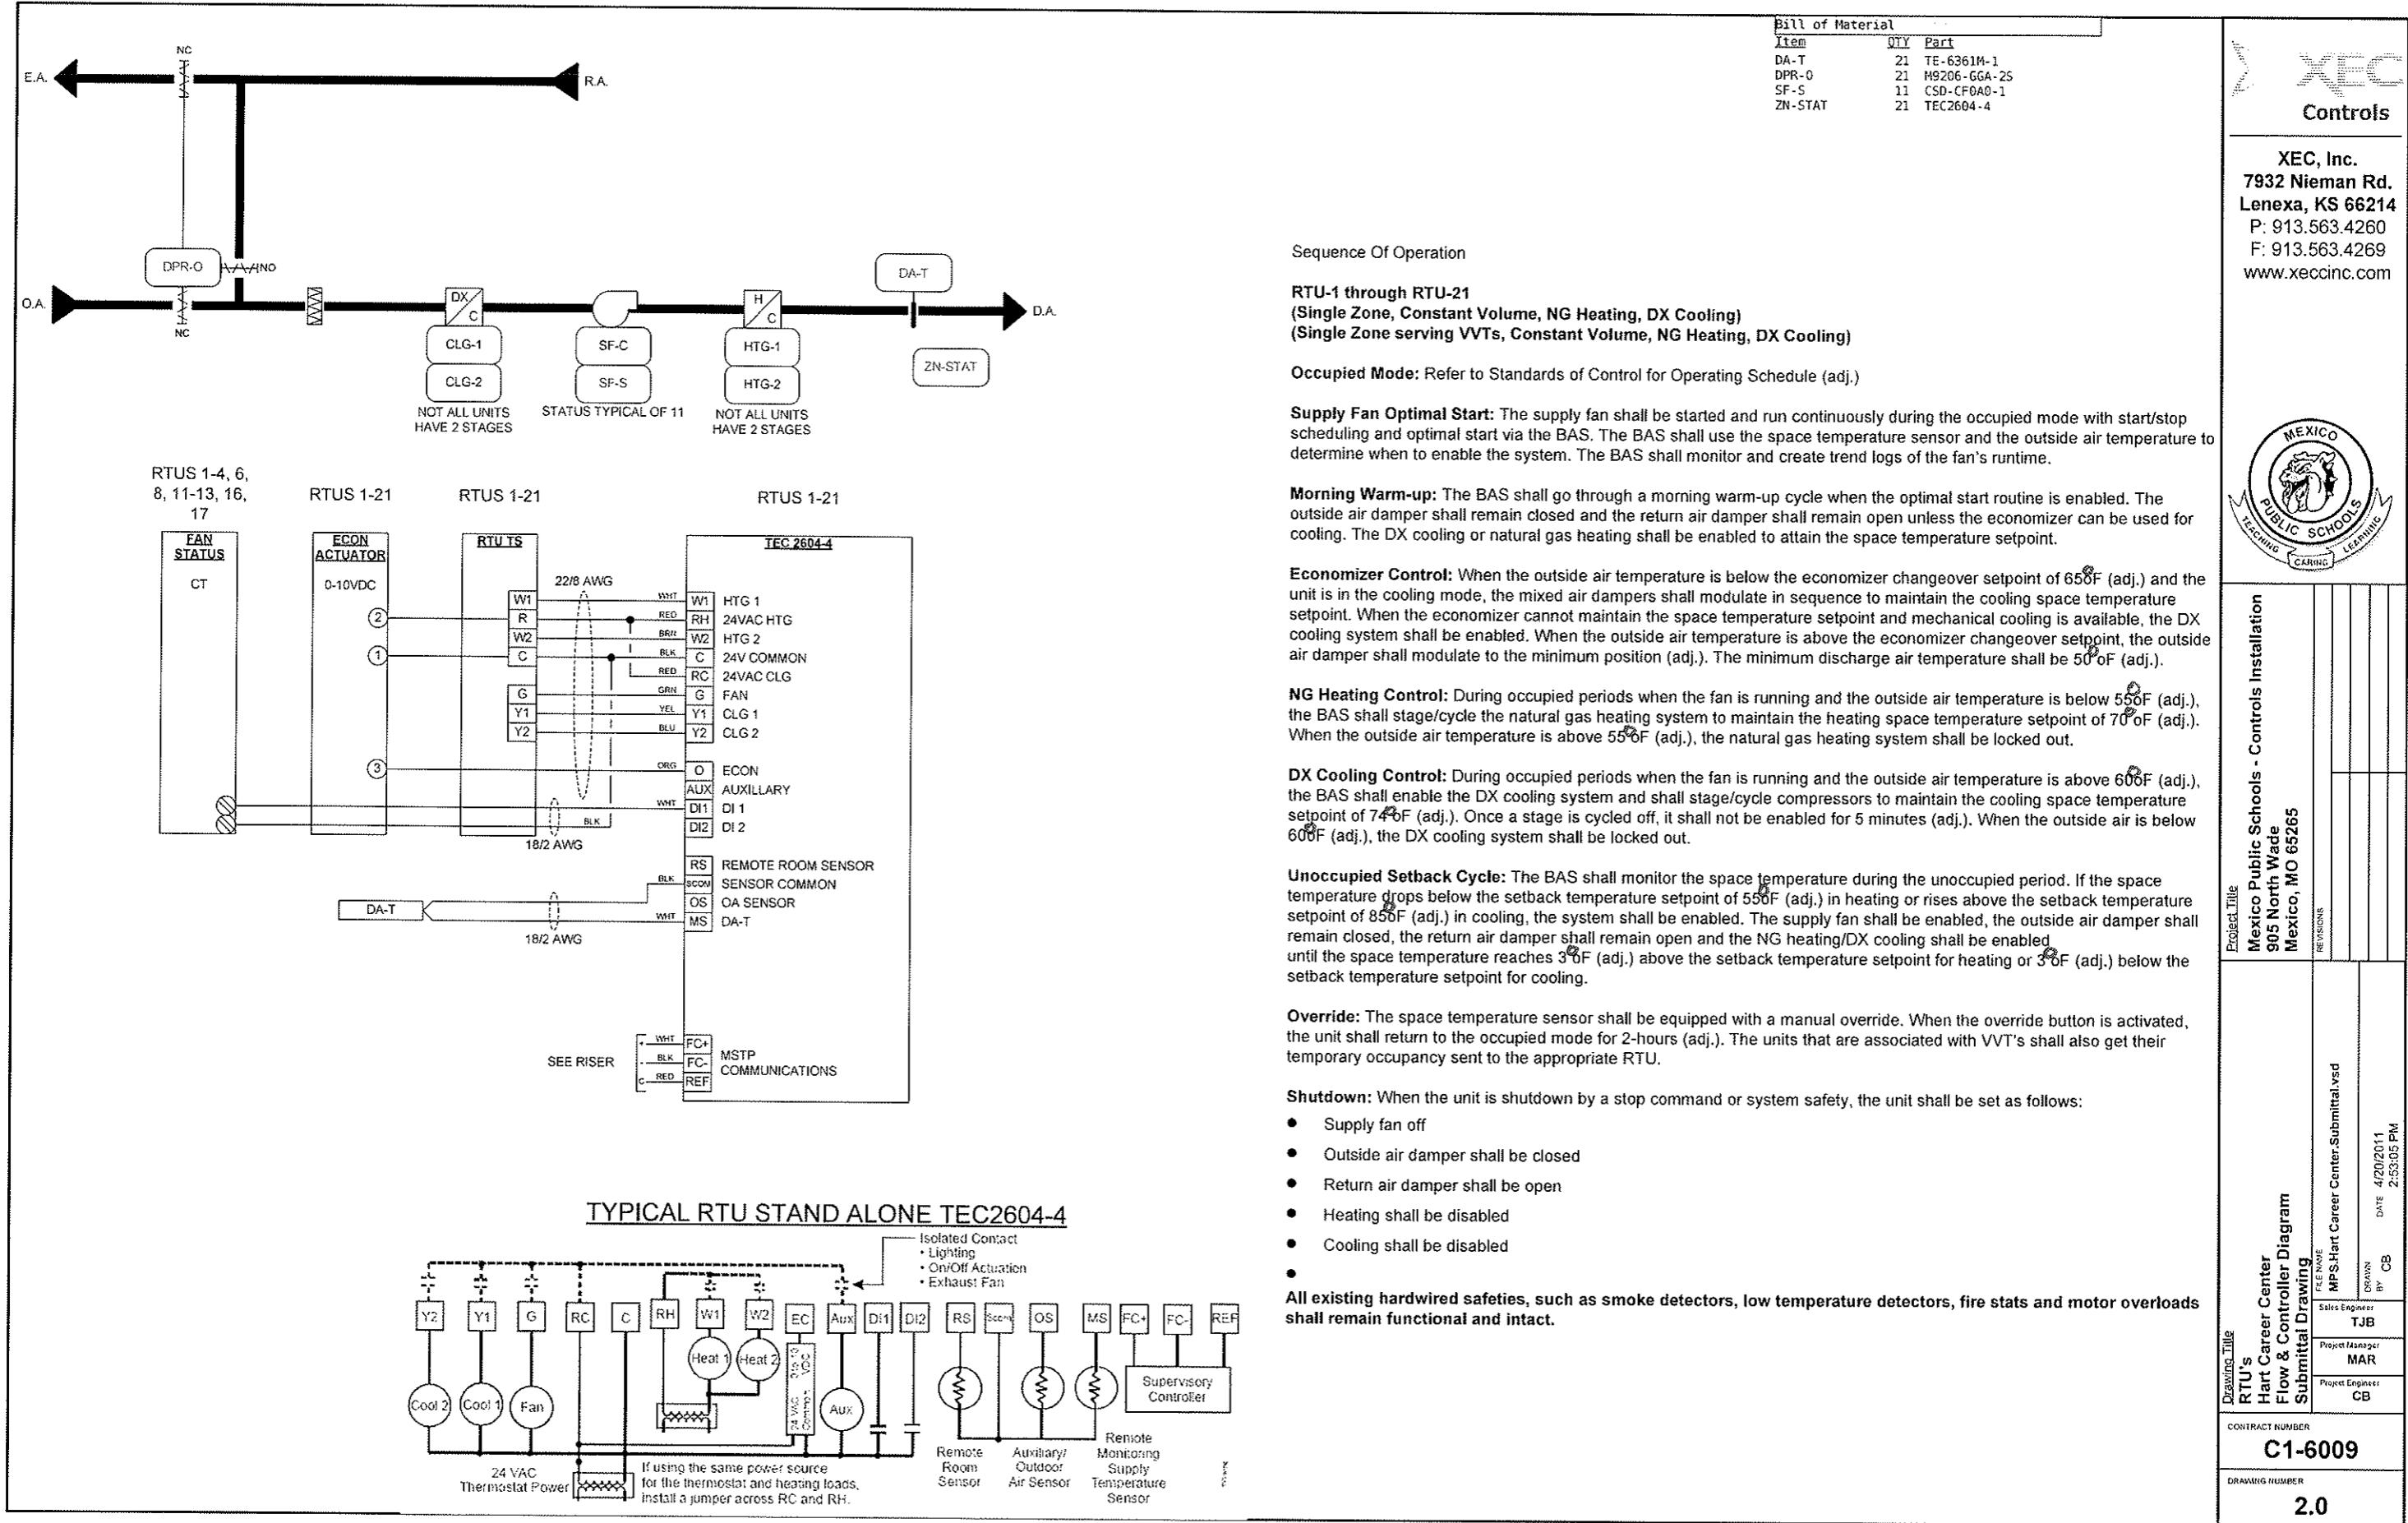





XEC, Inc.
7932 Nieman Rd.
Lenexa, KS 66214
P: 913.563.4260
F: 913.563.4269
www.xeccinc.com



Bill of Material		
Item	QTY	Part
R: EUH1-EN	1	V100
R: EUH2-EN	1	V100
R: EUH3-EN	1	V100
R: EUH4-EN	1	V100
R: EUH5-EN	1	V100
R: EUH6-EN	1	V100
R: EUH8-EN	1	V100
TX	9	X050CBA
VMA	9	MS-VMA1620-0
ZN-T,SP,O	9	NS-BTB7002-0
ZN2-T,SP,O	1	NS-BTB7003-0

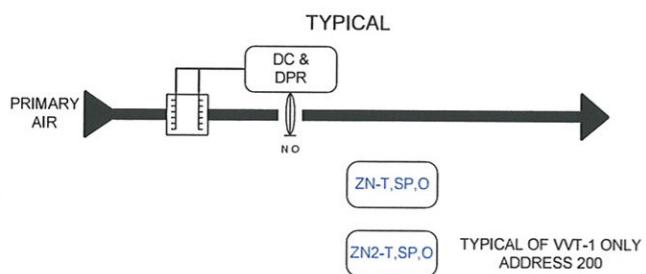

VVT CONTROLLER/ACTUATOR

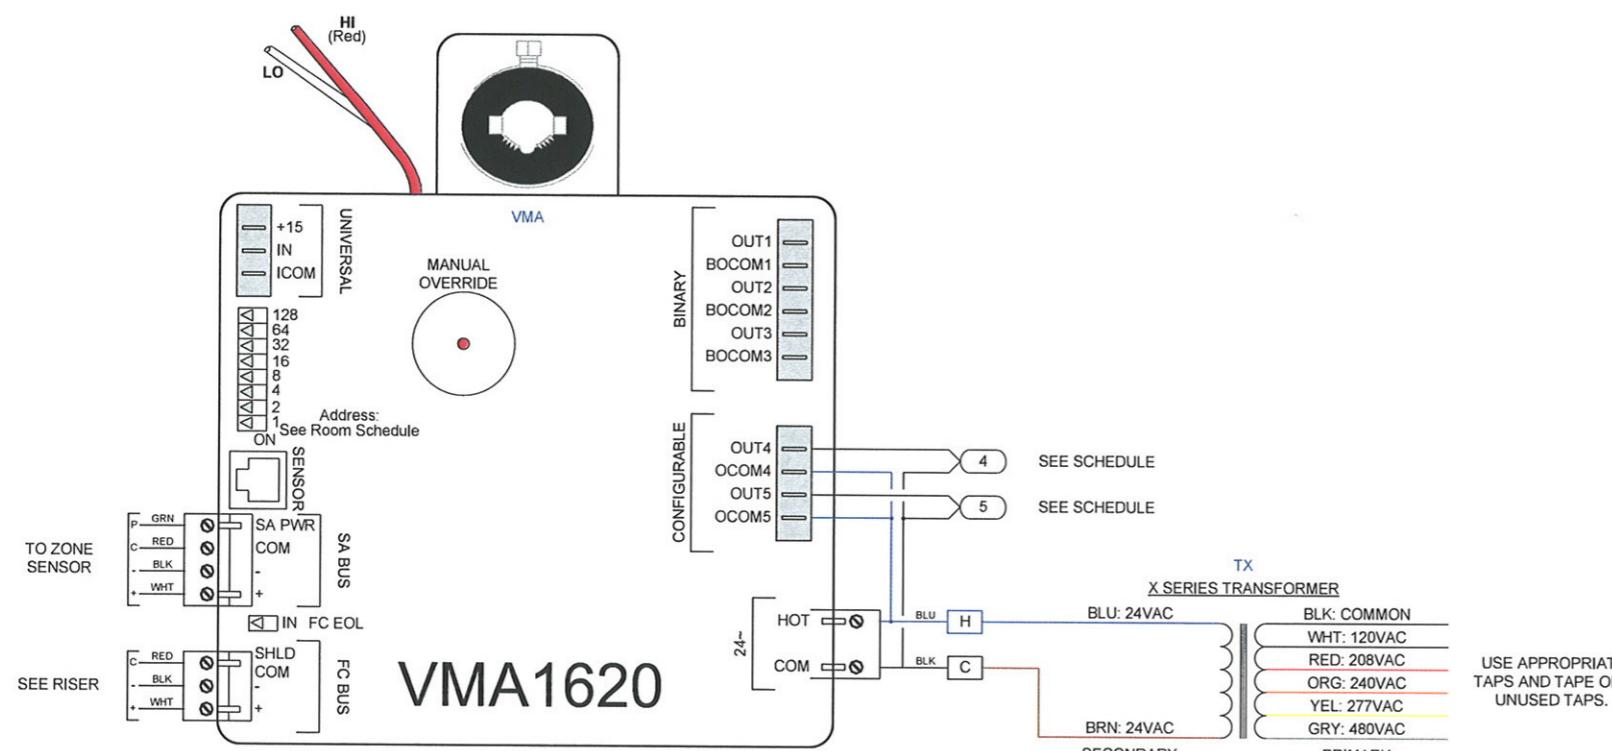

Sequence Of Operation

VVT Control

Occupied Mode: Refer to Standards of Control for Operating Schedule (adj.) Each VVT shall be enabled during the occupied mode. The BAS shall have the capability to schedule each VVT individually. The space temperature setpoint shall be controlled by the occupant or by the BAS and shall initially be 70 °F (adj.) in the heating mode and 74 °F (adj.) in the cooling mode. The VVT shall be in the same mode, heating or cooling, as the associated air handling unit. The VVT damper shall modulate to maintain the space temperature setpoint, when the space temperature is satisfied the VAV damper shall modulate to its minimum position (adj.).

Unoccupied Setback Cycle: During the unoccupied mode, the VVT damper shall remain open. The BAS shall monitor the space temperature during the unoccupied period. If the space temperature drops below the setback temperature setpoint of 55 °F (adj.), the VVT shall be enabled and the volume dampers on the remaining VVT's shall modulate to their minimum position until the space temperature at each VVT is 3 °F (adj.) above the setback temperature.

Override: Each space temperature sensor shall be equipped with a manual override. When the override button is activated, the respective VVT shall return to the occupied mode and the volume dampers on the remaining VAV boxes shall modulate to their minimum position for 2-hours (adj.).





CONTROLLER	OUTPUT	COMMAND POINT
VVT-1	BO4	EUH1-EN
VVT-1	BO5	EUH4-EN
VVT-2	BO4	EUH2-EN
VVT-2	BO5	EUH8-EN
VVT-6	BO4	EUH3-EN
VVT-6	BO5	EUH6-EN
VVT-9	BO4	EUH5-EN

Project Title	Mexico Public Schools - Controls Installation
Revisions	
Location	905 North Wade
City	Mexico, MO 65265

File Name	MPS.Hart Career Center-Submittal.vsd
Drawn By	CB
Date	4/20/2011 2:53:05 PM

Drawing Title	VVT's Hart Career Center Flow & Controller Diagram Submittal Drawing
Sales Engineer	TJB
Project Manager	MAR
Project Engineer	CB

Contract Number	C1-6009
Drawing Number	3.0

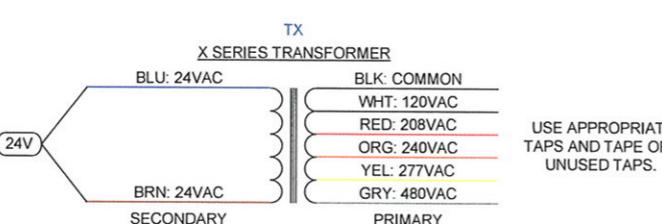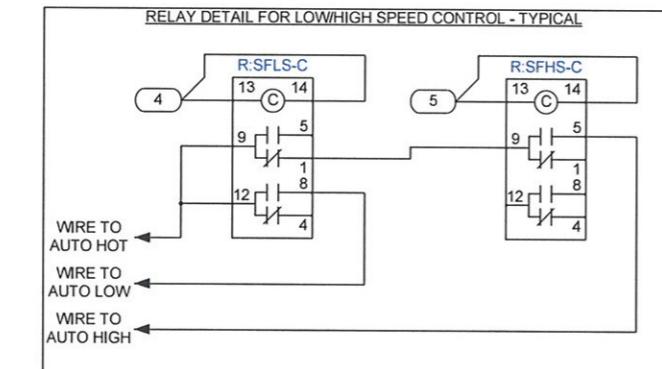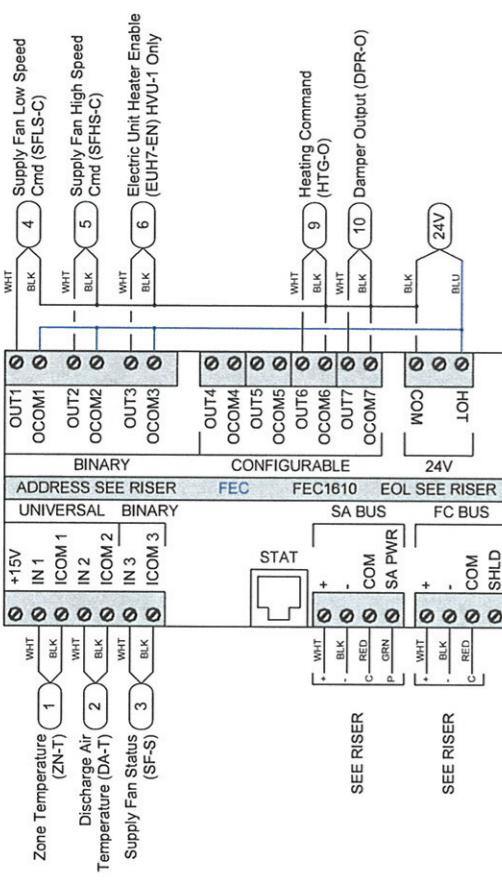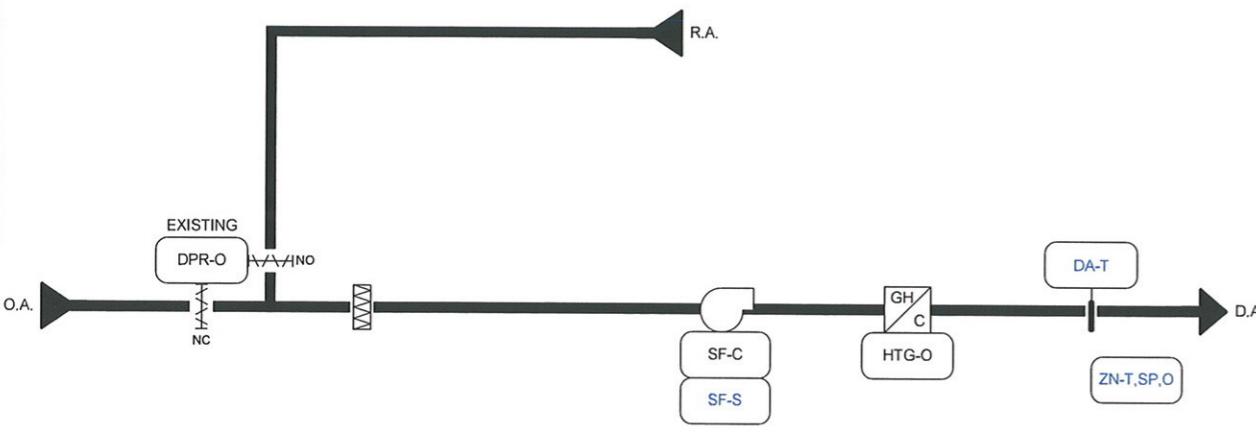

Bill of Material		
Item	QTY	Part
DA-T	4	TE-6311M-1
FEC	4	MS-FEC1611-0
R:EUH7-EN	1	V100
R:SFHS-C	4	RH2B-ULAC24V,SH2B-05
R:SFLS-C	4	RH2B-ULAC24V,SH2B-05
SF-S	4	CSD-CFOA0-1
TX	4	X050CBA
ZN-T,SP,O	4	NS-BTB7002-0

Sequence Of Operation

HVU-1 through HVU-4 (Constant Volume, NG Heating)

Occupied Mode: Refer to Standards of Control for Operating Schedule (adj.)

Supply Fan Optimal Start: The supply fan shall be started and run continuously during the occupied mode with start/stop scheduling and optimal start via the BAS. The BAS shall use the space temperature sensor and the outside air temperature to determine when to enable the system. If the supply fan status does not match the commanded value within 30 seconds (adj.), an alarm shall be sent to the operator work station. The BAS shall monitor and create trend logs of the fan's runtime.

Morning Warm-up: The BAS shall go through a morning warm-up cycle when the optimal start routine is enabled. The outside air damper shall remain closed and the return air damper shall remain open unless the economizer can be used for cooling. The natural gas heating shall be enabled to attain the space temperature setpoint.

Economizer Control: When the outside air temperature is below the economizer changeover setpoint of 65°F (adj.) and the space requires cooling, the mixed air dampers shall modulate in sequence to maintain the space temperature setpoint. When the outside air temperature is above the economizer changeover setpoint, the outside air damper shall modulate to the minimum position (adj.). The minimum discharge air temperature shall be 50°F (adj.).

NG Heating Control: During occupied periods when the fan is running and the outside air temperature is below 55°F (adj.), the BAS shall stage/cycle the natural gas heating system to maintain the heating space temperature setpoint of 70°F (adj.). When the outside air temperature is above 55°F (adj.), heating shall be locked out.

Unoccupied Setback Cycle: The BAS shall monitor the space temperature during the unoccupied period. If the space temperature drops below the setback temperature setpoint of 55°F (adj.) the system shall be enabled. The supply fan shall be enabled, the outside air damper shall remain closed, the return air damper shall remain open and the NG heating shall be enabled until the space temperature reaches 3°F (adj.) above the setback temperature setpoint.

Override: The space temperature sensor shall be equipped with a manual override. When the override button is activated, the unit shall return to the occupied mode for 2-hours (adj.).

Shutdown: When the unit is shutdown by a stop command or system safety, the unit shall be set as follows:

- Supply fan off
- Outside air damper shall be closed
- Return air damper shall be open
- Heating shall be disabled

All existing hardwired safeties, such as smoke detectors, low temperature detectors, fire stats and motor overloads shall remain functional and intact.

*Heating - Supply Fan low Speed
Cooling/ventilation - Supply Fan High Speed*


Project Title	Mexico Public Schools - Controls Installation	
905 North Wade	REVISIONS	
Mexico, MO 65265		
FILE NAME: MPS.Hart Career Center.Submittd.vsd		
DRAWN BY CB DATE 4/20/2011 2:33:05 PM		
Sales Engineer TJB		
Project Manager MAR		
Project Engineer CB		
Drawing Title	HVU's Hart Career Center Flow & Controller Diagram Submittal Drawing	
CONTRACT NUMBER	C1-6009	
DRAWING NUMBER	4.0	



Project Title	Mexico Public Schools - Controls Installation
Address	1101 East Anderson Street Mexico, MO 65265
Revisions	

FILE NAME:	MPS-Hart Career Center-Submittal.vsd
DRAWN BY:	CB
DATE:	4/20/2011 2:53:05 PM
Sales Engineer:	TJB
Project Manager:	MAR
Project Engineer:	CB

CONTRACT NUMBER:	C1-6009
DRAWING NUMBER:	5.0

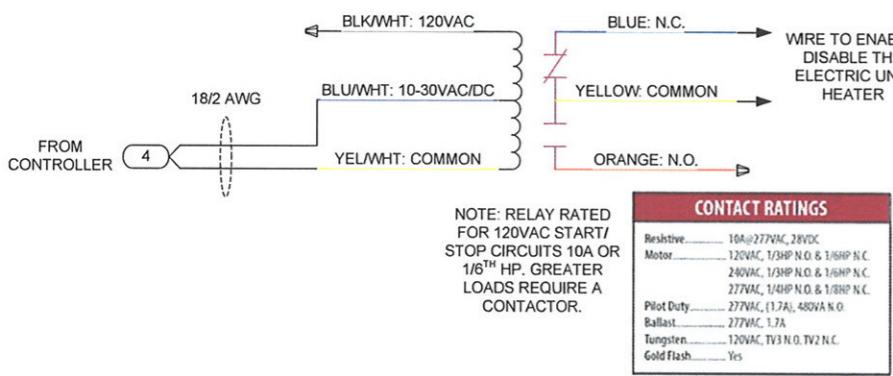

CONTROLLER	OUTPUT	COMMAND POINT	REF. PAGE
VVT-1	BO4	EUH1-EN	3.0
VVT-1	BO5	EUH4-EN	3.0
VVT-2	BO4	EUH2-EN	3.0
VVT-2	BO5	EUH8-EN	3.0
VVT-6	BO4	EUH3-EN	3.0
VVT-6	BO5	EUH6-EN	3.0
VVT-9	BO4	EUH5-EN	3.0
HVU-1	BO3	EUH7-EN	4.0

Sequence Of Operation

EUH-1 through EUH-8 (Electric Unit Heaters)

Occupied Mode: Refer to Standards of Control for Operating Schedule (adj.) During occupied periods when the outside air temperature is below 55 °F (adj.), the BAS shall enable the electric unit heaters; the units shall cycle to maintain the space temperature through their local controls. During the unoccupied periods when the outside air temperature is 40 °F (adj.) or above the units shall be disabled. When the outside air temperature is below 40 °F (adj.), the units shall remain enabled.

All existing hardwired safeties, such as smoke detectors, low temperature detectors, fire stats and motor overloads shall remain functional and intact.

CONTRACT NUMBER:	C1-6009
DRAWING NUMBER:	5.0